


VICINITY MAP
RTS

DETAIL AND SECTION REFERENCING

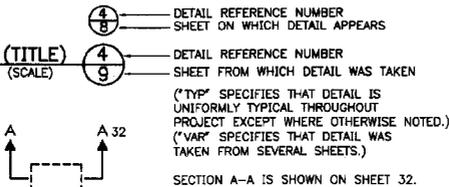

SECTION A-A 30

GENERAL NOTES

UNLESS OTHERWISE NOTED:

- LANDSCAPING THAT IS DAMAGED BY THE CONTRACTOR'S ACTIVITIES SHALL BE RESTORED IN KIND AS DIRECTED BY THE ENGINEER.
- EXISTING FACILITIES NOTED AS "EXISTING" ARE SHOWN IN LIGHT LINE WEIGHT AND NEW STRUCTURES ARE SHOWN IN HEAVY LINE WEIGHT.
- CONTRACTOR SHALL NOTIFY OWNERS OF ALL AFFECTED UNDERGROUND UTILITIES FOR FIELD LOCATING THEIR FACILITIES AT LEAST TWO DAYS IN ADVANCE. THE ONE-CALL "CALL BEFORE YOU DIG" NUMBER IS 1-800-424-5555.

ELECTRICAL NOTES

UNLESS OTHERWISE NOTED:

- ALL WIRE SHALL BE COPPER WITH THHN/THWN INSULATION AND RATED AT 600V. CONDUCTORS SIZED #10 OR SMALLER MAY BE SOLID; CONDUCTORS LARGER THAN #10 SHALL BE STRANDED. USE NEW WIRE FROM SERVICE POINT (SEATTLE CITY LIGHT CONNECTION) TO METER TO EXISTING FUSIBLE DISCONNECT IN STATION.
- ALL CONDUIT SHALL BE RIGID GALVANIZED STEEL (RGS) UNLESS OTHERWISE NOTED. WRAP ALL JOINTS WITH 20 MIL ALL-WEATHER CORROSION PROTECTION TAPE (SUCH AS SCOTCHRAP 51)
- CORE DRILL ALL CONDUIT PENETRATIONS THROUGH STRUCTURES UNLESS OTHERWISE NOTED.
- PROVIDE LINK SEAL MODULAR WALL SEALS FOR ALL CONDUIT PENETRATIONS UNLESS OTHERWISE NOTED. WALL OPENING SIZE SHALL BE AS RECOMMENDED BY WALL SEAL MANUFACTURER. GROUTING SHALL NOT BE USED.
- EXISTING CONDUIT LOCATIONS ARE APPROXIMATE. FIELD VERIFY.
- NEW CONDUIT LOCATIONS ARE NOT TO SCALE. ROUTE AS REQUIRED BY FIELD CONDITIONS. SUBMIT PLAN TO ENGINEER PRIOR TO INSTALLATION.
- REMOVE EXISTING NEUTRAL-GROUND BOND IN EXISTING HEAVY DUTY FUSIBLE DISCONNECT IN STATION. NEW SERVICE DISCONNECT IS LOCATED AT THE NEW METER-MAIN OUTSIDE THE STATION. ENSURE IT IS THE ONLY LOCATION OF A NEUTRAL GROUND BOND.
- THE GROUNDING ELECTRODE SHALL CONSIST OF TWO NEW GROUND RODS AND A CONCRETE ENCASED ELECTRODE (AT LEAST 20 FEET OF 1/2" D REBAR IN THE NEW CONCRETE SLAB PER 1999 NEC 250-50 (C)). EXISTING GROUND ROD CONNECTION TO GROUND BUS IN EXISTING DISCONNECT IN STATION TO REMAIN (REMOVE BOND TO NEUTRAL SEE NOTE 7).

STRUCTURAL NOTES

UNLESS OTHERWISE NOTED:

MATERIAL:

CONCRETE: PORTLAND CEMENT CONCRETE SHALL BE IN ACCORDANCE WITH THE STANDARD SPECIFICATIONS AND THE SPECIAL PROVISIONS.

CLASS AX FOR WALL CONSTRUCTION.
f'c = 4,000 PSI, f'c = 1,600 PSI

REINFORCING STEEL: REINFORCING STEEL SHALL CONFORM TO AASHTO M31 (ASTM A615) GRADE 60. CONCRETE COVER TO BE 2 INCHES

STRUCTURAL STEEL: STRUCTURAL CARBON STEEL FOR SHAPES AND PLATES SHALL CONFORM TO AASHTO M183 (ASTM A36); ALL STRUCTURAL STEEL SHALL BE HOT DIP GALVANIZED AFTER FABRICATION.

MACHINE BOLT: MACHINE BOLTS SHALL CONFORM TO ASTM-A307 AS SHOWN ON THE PLANS.


PREFORMED JOINT FILLER: PREFORMED JOINT FILLER SHALL MEET THE REQUIREMENTS OF AASHTO M33, M153, OR M213; EXCEPT EXPANDED POLYSTYRENE SHALL MEET AASHTO M230.

ALL CONNECTION MATERIALS, SUCH AS PLATES, ANGLES, POST BASES, MACHINE BOLTS, STAPLES, NAILS, SCREWS, CABLES, SWAGE SOCKETS, EYE BOLTS, TURNBUCKLES, ANCHORS, AND HARDWARES ETC. SHALL BE GALVANIZED.


WELDING SHALL CONFORM TO THE CODES AND PROVISIONS SPECIFIED IN THE STATE OF WASHINGTON STANDARD SPECIFICATIONS FOR ROAD AND BRIDGE CONSTRUCTION 1991 AND CURRENT AMENDMENTS THERETO. WELDING ELECTRODES SHALL BE E70XX.

SHEET INDEX


SHT NO.	SHEET DESCRIPTION
1	VICINITY MAP, DETAIL & SECTION REFERENCING, SHT INDEX NOTES
2-3	PUMP STATION #2, 901 LAKESIDE AVE S
4	PUMP STATION #6, 4845 LAKE WASHINGTON BLVD. S. PUMP STATION #45, 7609 PERIMETER ROAD S
5-6	ELECTRICAL DETAILS & NOTES

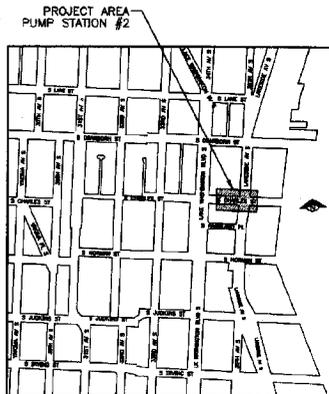

LOCATION MAP
SCALE: 1" = 400'

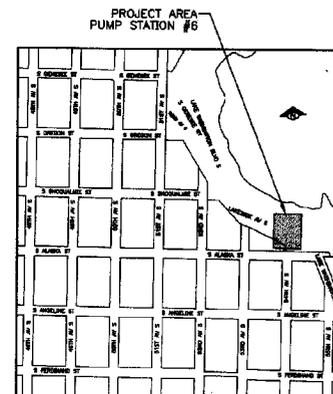

LOCATION MAP
SCALE: 1" = 400'

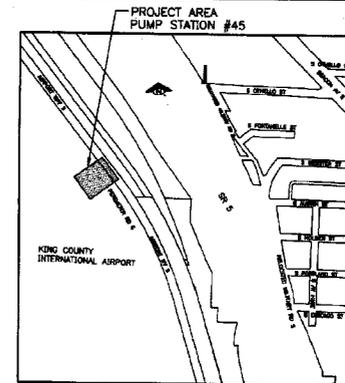

LOCATION MAP
SCALE: 1" = 400'



777-544-1

APPROVED FOR ADVERTISING
DIGNITY DIVELY
DIRECTOR OF FINANCE
SEATTLE, WASHINGTON 12-12-2001
BY: Elizabeth Alger
CONSTRUCTING MANAGER

NAME OR INITIALS AND DATE
DESIGNED BY: [Signature]
CHECKED BY: [Signature]
DRAWN BY: [Signature]
CHECKED BY: [Signature]
ALL WORK DONE IN ACCORDANCE WITH THE CITY OF SEATTLE STANDARD PLANS AND SPECIFICATIONS AND OTHER DOCUMENTS REFERRED TO IN SECTION 0-2.2 OF THE PUBLIC SIGNAL.

INITIALS AND DATE
REVIEWED: [Signature]
DES: [Signature]
REVISION: [Signature]
RECEIVED: [Signature]
REVERED AS SHOWN




City of Seattle
Seattle Public Utilities
Diana Gale, Director
ORDINANCE NO. [Blank]
FUND: [Blank]
SCALE: AS NOTED
INSPECTOR'S BOOK: [Blank]

PUMP STATION IMPROVEMENT
PUMP STATION #2, #6, #45


PC C3AA406
R/W CO C3AA406
VALVE PLAN NO. 777-544
SHEET 1 OF 6

KCSlip04 33945


SEA4000492

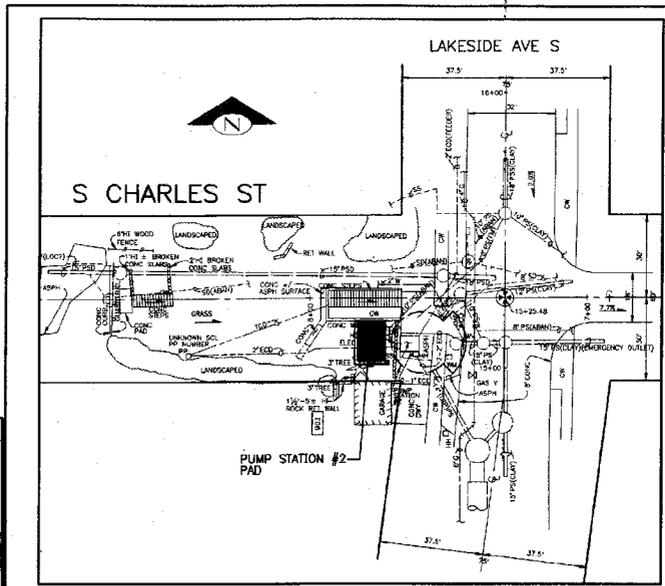

SITE PLAN
SCALE: 1"=20'

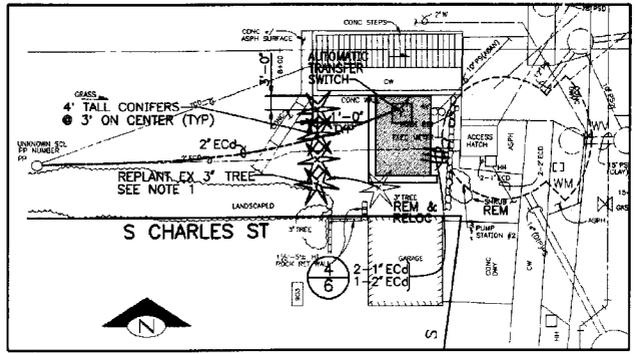

PUMP STATION #2 - IMPROVEMENT PLAN
SCALE: 1"=10'

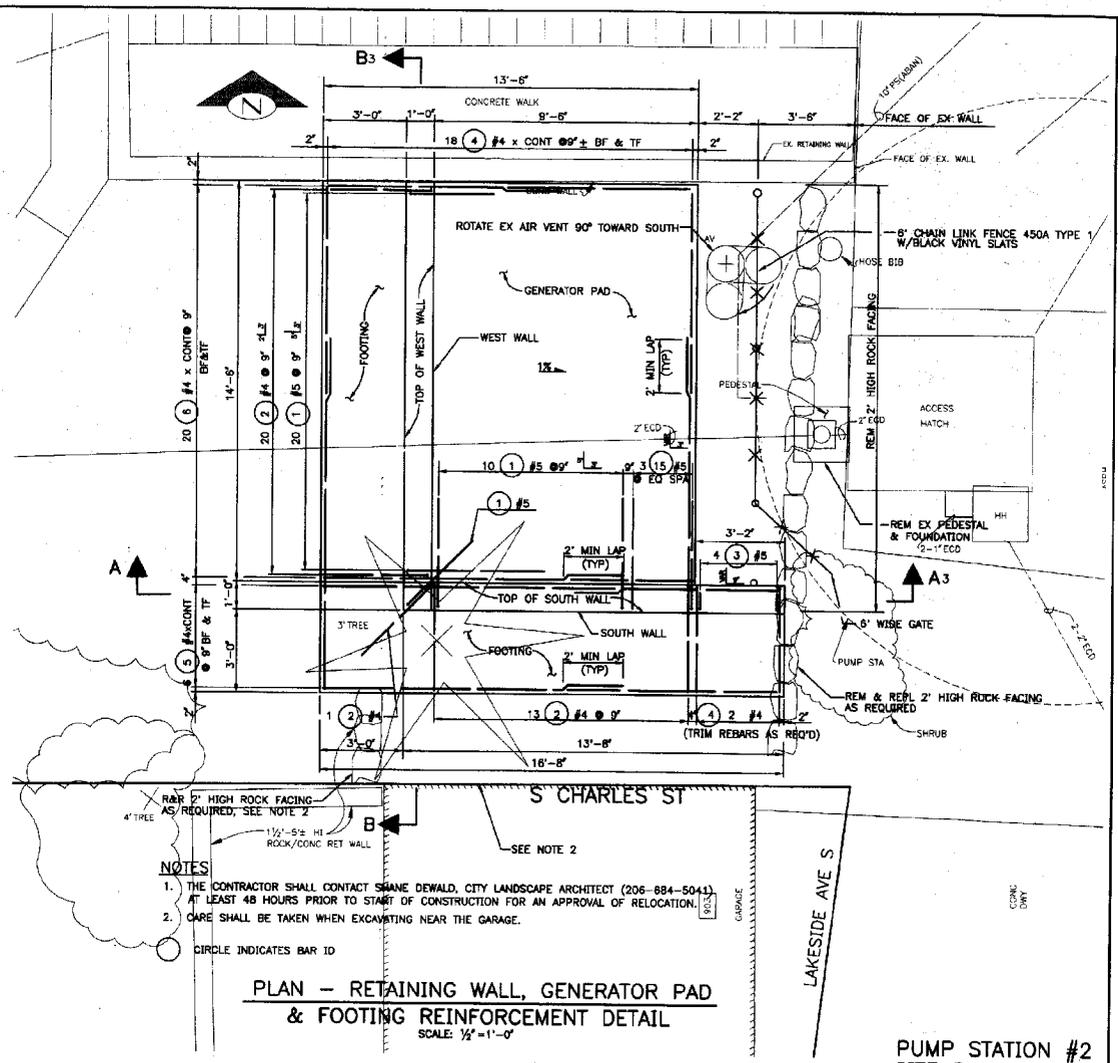

PLAN - RETAINING WALL, GENERATOR PAD & FOOTING REINFORCEMENT DETAIL
SCALE: 1/2"=1'-0"

NOTES

1. THE CONTRACTOR SHALL CONTACT SHANE DEWALD, CITY LANDSCAPE ARCHITECT (206-884-5041) AT LEAST 48 HOURS PRIOR TO START OF CONSTRUCTION FOR AN APPROVAL OF RELOCATION.
2. CARE SHALL BE TAKEN WHEN EXCAVATING NEAR THE GARAGE.

CIRCLE INDICATES BAR ID



APPROVED FOR ADVERTISING
DWIGHT DIVELY
DIRECTOR OF FINANCE
SEATTLE, WASHINGTON 20

NAME OR INITIALS AND DATE
REVIEWED: *DL*
CHECKED: *DL*

INITIALS AND DATE
REVIEWED: *DL*
CHECKED: *DL*




City of Seattle
Seattle Public Utilities
Diana Gale, Director

**PUMP STATION IMPROVEMENT
PUMP STATION #2, #6, #45**


PC C3A4406
R/W C3A4406
CD 777-544
SHEET 2 OF 6

KCSlip04 33946


SEA4000493

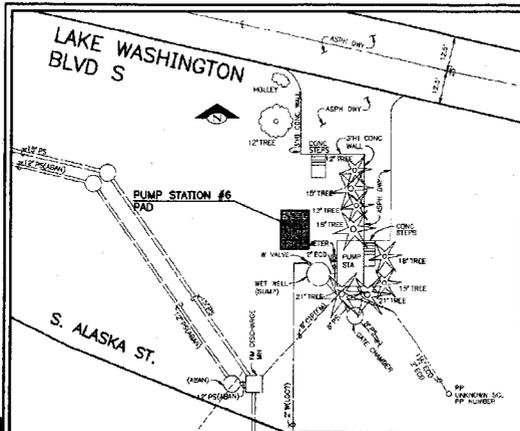


SITE PLAN
SCALE: 1"=20'

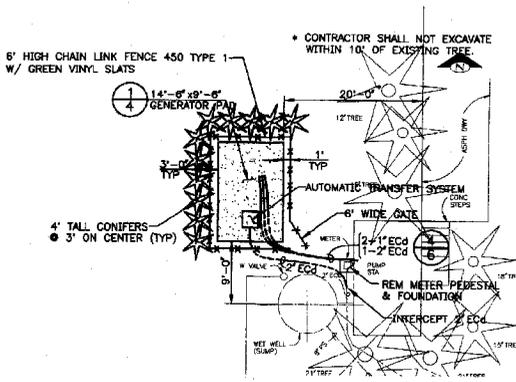


PUMP STATION #6 - IMPROVEMENT PLAN
SCALE: 1"=10'

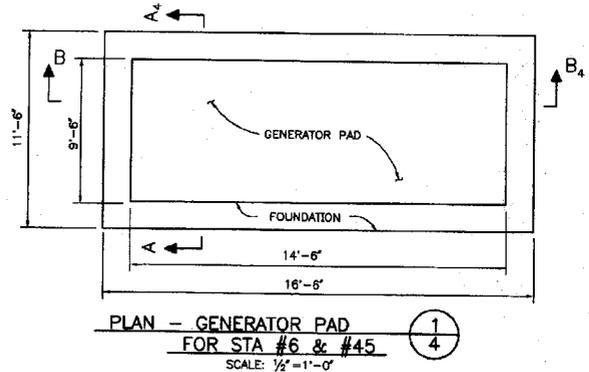


PLAN - GENERATOR PAD
FOR STA #6 & #45
SCALE: 1/2"=1'-0"

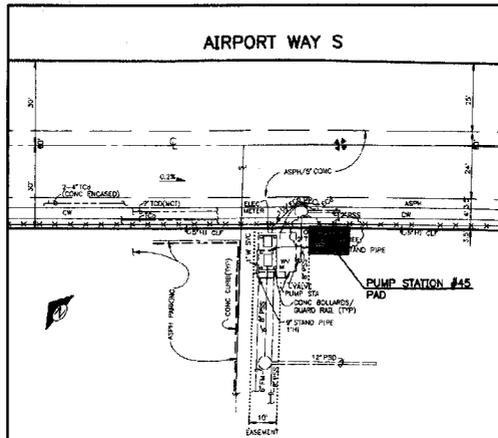

SITE PLAN
SCALE: 1"=20'

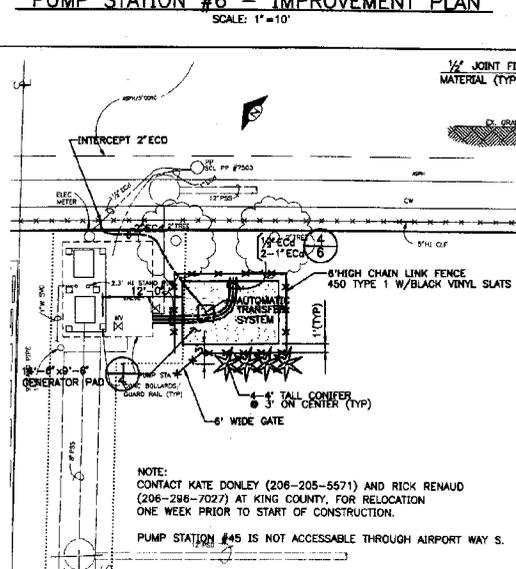


PUMP STATION #45 - IMPROVEMENT PLAN
SCALE: 1"=10'

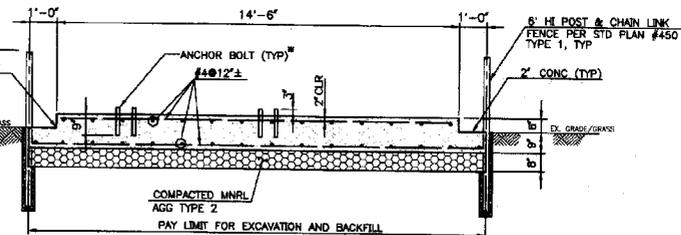

SECTION B-B
SCALE: 1/2"=1'-0"

- * NOTE:
1. ANCHOR BOLT AND CONDUIT LOCATIONS PER MANUFACTURER
2. GENERATOR SHALL BE LOCATED ON THE CENTER OF THE GENERATOR PAD.

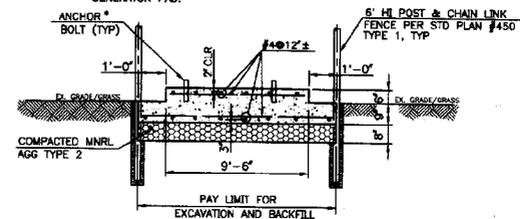

SECTION A-A
SCALE: 1/2"=1'-0"

**PUMP STATION #6 & #45
SITE PLANS & PLANS**

Property of City of Seattle
777 644-4

APPROVED FOR ADVERTISING
DWIGHT DIVELY
DIRECTOR OF FINANCE
SEATTLE, WASHINGTON 20

NAME OR INITIALS AND DATE	INITIALS AND DATE
DESIGNED: [Signature]	REVIEWED: [Signature]
CHECKED: [Signature]	PREPARED: [Signature]
DRAWN: [Signature]	RECEIVED: [Signature]
CHECKED: [Signature]	REVISED AS BUILT: [Signature]




City of Seattle
Seattle Public Utilities
Diana Gale, Director

**PUMP STATION IMPROVEMENT
PUMP STATION #2, #6, #45**

PC C3AA406
R/W C3AA406
VALVE PLAN NO. 777-544
SHEET 4 OF 6

KCSlip04 33948

SEA4000495

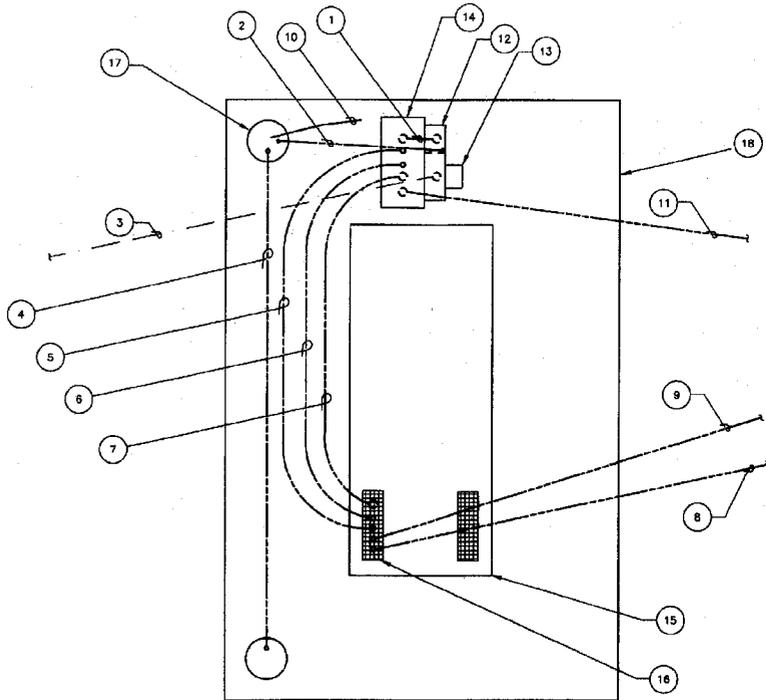

TYPICAL ELECTRICAL DETAIL
NTS

PUMP STA #2 - LOAD CALCULATIONS

LOAD	VOLTS	PHASES	AMPS	FACTOR	KVA
PUMP #1 (10 HP) (EXISTING)	240	3	28	1.25	14.5
PUMP #2 (10 HP) (EXISTING)	240	3	28	1.00	11.6
1 PHASE PANEL (EXISTING LOAD)	240/120	1	24	1.00	5.8
1 PHASE PANEL (NEW LOAD)	120	1	12	1.25	1.8
TOTAL					33.7**

** 81A PER PHASE

PUMP STA #6 - LOAD CALCULATIONS

LOAD	VOLTS	PHASES	AMPS	FACTOR	KVA
PUMP #1 (5 HP) (EXISTING)	240	3	15.2	1.25	7.9
PUMP #2 (5 HP) (EXISTING)	240	3	15.2	1.00	6.3
1 PHASE PANEL (EXISTING LOAD)	240/120	1	18	1.00	4.4
1 PHASE PANEL (NEW LOAD)	120	1	12	1.25	1.8
TOTAL					20.4**

** 49A PER PHASE

PUMP STA #45 - LOAD CALCULATIONS

LOAD	VOLTS	PHASES	AMPS	FACTOR	KVA
PUMP #1 (10 HP) (EXISTING)	240	3	28	1.25	14.5
PUMP #2 (10 HP) (EXISTING)	240	3	28	1.00	11.6
1 PHASE PANEL (EXISTING LOAD)	240/120	1	16	1.00	3.8
1 PHASE PANEL (NEW LOAD)	120	1	12	1.25	1.8
TOTAL					31.7**


** 76A PER PHASE

KEYED NOTES

- UNLESS OTHERWISE NOTED:
- 1 2" RGS POWER CONDUIT FROM SERVICE DISCONNECT TO TRANSFER SWITCH (4 #2 THHN)
 - 2 3/4" SCHED. 80 PVC CONDUIT FROM SERVICE DISCONNECT TO GROUND ROD WELL (1 #4 BARE STRANDED CU)
 - 3 FOR PUMP STATION #2 AND #6. 2" RGS POWER CONDUIT FROM METER TO INTERCEPTED EXISTING 2" CONDUIT FROM POLE (4 #2 THHN). FOR PUMP STATION #45. 2" RGS POWER CONDUIT FROM METER TO AND UP POLE PER SEATTLE CITY LIGHT REQUIREMENTS (4 #2 THHN). REMOVE EXISTING 1-1/2" CONDUIT.
 - 4 3/4" SCHED. 80 PVC CONDUIT BETWEEN GROUND ROD WELLS (1 #4 BARE STRANDED CU)
 - 5 1" RGS SIGNAL CONDUIT FROM TRANSFER SWITCH TO GENERATOR (14 #16 THHN)
 - 6 1" RGS CONTROL CONDUIT FROM TRANSFER SWITCH TO GENERATOR (5 #16 THHN)
 - 7 2" RGS POWER CONDUIT FROM TRANSFER SWITCH TO GENERATOR (4 #2 THHN)
 - 8 1" RGS SIGNAL CONDUIT FROM GENERATOR TO TELEMETRY PANEL IN STATION (14 #16 THHN). SEE WALL PENETRATION DETAIL $\frac{4}{8}$
 - 9 1" RGS POWER CONDUIT FROM GENERATOR TO POWER DISTRIBUTION PANEL IN STATION (3 #10 THHN). SEE WALL PENETRATION DETAIL $\frac{4}{8}$
 - 10 #4 BARE STRANDED CU CONDUCTOR FROM REBAR CONNECTION TO GROUNDING ELECTRODE CONDUCTOR CONNECTION IN GROUND ROD WELL. SEE DETAIL $\frac{1}{8}$
 - 11 POWER CONDUIT FROM TRANSFER SWITCH TO INTERCEPTED EXISTING POWER CONDUIT TO EXISTING MAIN FUSIBLE DISCONNECT INSIDE STATION. (4 #2 THHN) FOR STATION #2 AND #6 - 2" RGS. FOR STATION #45 - 1 1/2" RGS. SEE WALL PENETRATION DETAIL $\frac{4}{8}$
 - 12 COMBINATION METER/MAIN - SAFETY SOCKET WITH FACTORY INSTALLED 100 AMP BREAKER AND TEST/BYPASS FACILITIES.
 - 13 METER: FURNISHED BY CONTRACTOR (SUPPLIED AND INSTALLED BY SEATTLE CITY LIGHT).
 - 14 ONAN AUTOMATIC TRANSFER SWITCH: SUPPLIED BY CITY, INSTALLED BY CONTRACTOR. WHERE AS DIRECTED BY INSTALLATION MANUALS. SUBMIT PLAN FOR APPROVAL.
 - 15 ONAN 50 KW GENERATOR IN QUIET SITE II ENCLOSURE: SUPPLIED BY CITY, INSTALLED BY CONTRACTOR. FOR PUMP STATION #2 AND #45. ONAN 35 KW GENERATOR IN QUIET SITE II ENCLOSURE: SUPPLIED BY CITY, INSTALLED BY CONTRACTOR. FOR PUMP STATION #6.
 - 16 CONDUIT STUB UP AREA PER MANUFACTURER REPRESENTATIVE. VERIFY WITH ACTUAL UNIT BEFORE FINALIZING CONDUIT RUNS.
 - 17 ONE OF TWO GROUND ROD WELLS. SEE DETAIL $\frac{1}{8}$ SECOND WELL SIMILAR BUT ONLY WITH GROUND ROD CONNECTION.
 - 18 TOP SURFACE OF GROUND ROD WELLS SHALL BE AT THE FINISH GRADE OF THE TOP SURFACE OF THE CONCRETE PAD. 9'-6" X 14'-6" CONCRETE PAD.

ELECTRICAL DETAILS & NOTES

**PUMP STATION IMPROVEMENT
PUMP STATION #2, #6, #45**

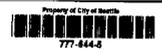

APPROVED FOR ADVERTISING
DWAYNE DIVELY
DIRECTOR OF FINANCE
SEATTLE, WASHINGTON 20

NAME OR INITIALS AND DATE
DESIGNED: [Signature] 1/12/04
CHECKED: [Signature] 1/12/04

INITIALS AND DATE
REVIEWED: [Signature] 1/12/04
DATE: 1/12/04
DESIGNED: [Signature] 1/12/04
CHECKED: [Signature] 1/12/04



City of Seattle
Seattle Public Utilities
Diana Gale, Director

ORDINANCE NO. _____
FUND: _____
SCALE: AS NOTED
INSPECTOR'S BOOK

PC C3AAA06
R/W
CO C3AAA06
VALET PLAN NO. 777-544
SHEET 5 OF 6


KCSlip4 33949

SEA4000496


TABLE FOR LINK SEAL

PENETRATING PIPE #"	CORE SIZE	LINK SEAL PRODUCT OR APPROVED EQUAL
1"	3"	LS-300-4 LINKS
1½"	3½"	LS-300-5 LINKS
2"	4"	LS-300-6 LINKS


* DIAMETERS SHOWN ARE FOR WALL PENETRATION SEALS MADE BY LINK SEAL.

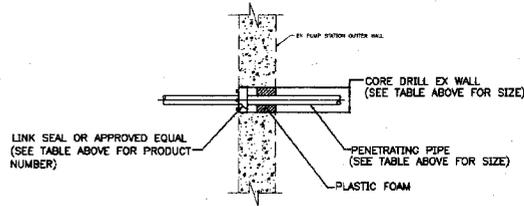

WALL PENETRATION DETAIL 4
NTS 2,4

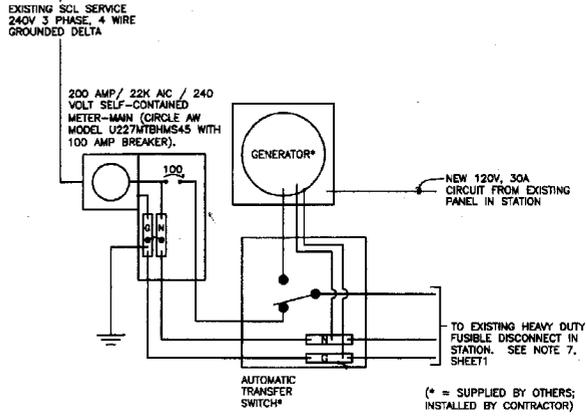

TYPICAL ONE LINE DIAGRAM
NTS

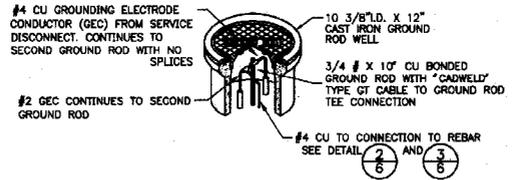


GROUND ROD DETAIL 1
NTS 5



*CADWELD TYPE RR END CABLE TO REBAR CONNECTION

CABLE TO REBAR CONNECTION DETAIL 2
NTS 6

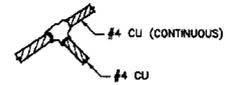

*CADWELD TYPE TA CABLE TO CABLE TEE CONNECTION

CABLE CONNECTION DETAIL 3
NTS 6



777-544-8

APPROVED FOR ADVERTISING
SWIGHT DIVELY
DIRECTOR OF FINANCE
SEATTLE, WASHINGTON 20

BY: CONTRACTING MANAGER

NAME OR INITIALS AND DATE
DESIGNED: [Signature] 11/13/03
CHECKED: [Signature] 11/13/03
DRAWN: [Signature]
REVISIONS: AS BUILT

INITIALS AND DATE
REVIEWED: [Signature] 11/13/03
CONSTR. PROJ. MGR.: [Signature]
REVISIONS: AS BUILT



City of Seattle
Seattle Public Utilities
Diana Gale, Director
ORDINANCE NO. APPROVED
FILED: AS NOTED
SCALE: AS NOTED
INSPECTOR'S BOOK

ELECTRICAL DETAILS
PUMP STATION IMPROVEMENT
PUMP STATION #2, #6, #45
SHEET 6 OF 6

KCSlip04 339350

SEA4000497